



DEPARTMENT OF REGULATORY AND ECONOMIC RESOURCES (RER)  
BOARD AND CODE ADMINISTRATION DIVISION

## NOTICE OF ACCEPTANCE (NOA)

MIAMI-DADE COUNTY  
PRODUCT CONTROL SECTION

11805 SW 26 Street, Room 208  
Miami, Florida 33175-2474  
T (786) 315-2590 F (786) 315-2599

[www.miamidade.gov/economy](http://www.miamidade.gov/economy)

**Amarr Garage Doors**  
**165 Carriage Court**  
**Winston-Salem, NC 27105**

**SCOPE:** This NOA is being issued under the applicable rules and regulations governing the use of construction materials. The documentation submitted has been reviewed and accepted by Miami-Dade County RER-Product Control Section to be used in Miami Dade County and other areas where allowed by the Authority Having Jurisdiction (AHJ). This NOA shall not be valid after the expiration date stated below. The Miami-Dade County Product Control Section (In Miami Dade County) and/or the AHJ (in areas other than Miami Dade County) reserve the right to have this product or material tested for quality assurance purposes. If this product or material fails to perform in the accepted manner, the manufacturer will incur the expense of such testing and the AHJ may immediately revoke, modify, or suspend the use of such product or material within their jurisdiction. RER reserves the right to revoke this acceptance, if it is determined by Miami-Dade County Product Control Section that this product or material fails to meet the requirements of the applicable building code.

This product is approved as described herein, and has been designed to comply with the Florida Building Code, including the High Velocity Hurricane Zone.

**DESCRIPTION: Model 950 Heritage & 655 Oak Summit 1000, 2000 Steel Sectional Garage Door up to 18'-0" Wide**

**APPROVAL DOCUMENT:** Drawing No. IRC-9518-165-26-I, titled "Model 950 Heritage and Model 655 Oak Summit (24ga) 1000, 2000 Short, Long, Flush and Oak Summit Panels", sheets 1 through 3 of 3, dated 06/07/2007, with revision C dated 04/02/2013, prepared by Amarr Garage Doors, signed and sealed by Thomas L. Shelmerdine, P.E., bearing the Miami-Dade County Product Control revision stamp with the Notice of Acceptance number and expiration date by the Miami-Dade County Product Control Section.

**MISSILE IMPACT RATING: Large and Small Missile Impact Resistant**

**LABELING:** A permanent label with the manufacturer's name or logo, 3800 Greenway Circle, Lawrence, Kansas, model number, the positive and negative design pressure rating, indicate impact rated if applicable, installation instruction drawing reference number, approval number (NOA), the applicable test standards, and the statement reading 'Miami-Dade County Product Control Approved' is to be located on the door's side track, bottom angle, or inner surface of a panel.

**RENEWAL** of this NOA shall be considered after a renewal application has been filed and there has been no change in the applicable building code negatively affecting the performance of this product.

**TERMINATION** of this NOA will occur after the expiration date or if there has been a revision or change in the materials, use, and/or manufacture of the product or process. Misuse of this NOA as an endorsement of any product, for sales, advertising or any other purposes shall automatically terminate this NOA. Failure to comply with any section of this NOA shall be cause for termination and removal of NOA.

**ADVERTISEMENT:** The NOA number preceded by the words Miami-Dade County, Florida, and followed by the expiration date may be displayed in advertising literature. If any portion of the NOA is displayed, then it shall be done in its entirety.

**INSPECTION:** A copy of this entire NOA shall be provided to the user by the manufacturer or its distributors and shall be available for inspection at the job site at the request of the Building Official.

This NOA revises NOA # 13-0503.05 and consists of this page 1 and evidence page E-1, as well as approval document mentioned above.

The submitted documentation was reviewed by Carlos M. Utrera, P.E.



*[Signature]*  
07/09/2015

NOA No. 15-0505.10  
Expiration Date: October 4, 2017  
Approval Date: July 16, 2015  
Page 1

**Amarr Garage Doors**

**NOTICE OF ACCEPTANCE: EVIDENCE SUBMITTED**

**A. DRAWINGS “Submitted under NOA # 13-0503.05”**

1. Drawing No. **IRC-9518-165-26-I**, titled “Model 950 Heritage and Model 655 Oak Summit (24ga) 1000, 2000 Short, Long, Flush and Oak Summit Panels”, Sheets 1 through 3 of 3, dated 06/07/2007, with revision C dated 04/02/2013, prepared by Amarr Garage Doors, signed and sealed by Thomas L. Shelmerdine, P.E.

**B. TESTS “Submitted under NOA # 12-0228.04”**

1. Test report on Evaluation of Painted or Coated Specimens Subjected to Corrosive Environments per ASTM D1654 & ASTM B117, prepared by Architectural Testing, Inc., Test Report # **A7420.01-106-18**, dated 04/12/2011, signed and sealed by Joseph A. Reed, P.E.

**“Submitted under NOA # 12-0228.09”**

2. Test report on Forced Entry Test per FBC, TAS 202-94, prepared by American Test Lab, Inc., Test Report # **ATLNC 0912.01-11**, dated 10/13/2011, signed and sealed by David W. Johnson, P.E.

**“Submitted under NOA # 07-0820.04”**

3. Test report on 1) Uniform Static Air Pressure Test, per FBC TAS 202-94,  
2) Large Missile Impact Test, per FBC TAS 201-94,  
3) Cyclic Wind Pressure Test, per FBC TAS 203-94,  
along with marked-up drawings, prepared by American Test Lab, Inc., Report # **ATLNC 0604.02-07**, dated 06/30/07, signed and sealed by David W. Johnson, P.E.
4. Test report on Tensile Test for 3 Samples per ASTM E 8, prepared by Hurricane Engineering & Testing Inc., Report # **HETI-07-T735**, dated 06/26/2007, signed and sealed by Candido F. Font, P.E.

**C. CALCULATIONS “Submitted under NOA # 12-0228.04”**

1. Anchor calculations prepared by Structural Solutions, P.A., dated 01/25/2012, signed and sealed by Thomas L. Shelmerdine, P.E.

**D. QUALITY ASSURANCE**


1. Miami-Dade Department of Regulatory and Economic Resources (RER)

**E. MATERIAL CERTIFICATIONS**

1. None.

**F. STATEMENTS**

1. Statement letter of code conformance to the 5<sup>th</sup> edition (2014) FBC and no financial interest issued by Structural Solutions, PA., dated 04/08/2015, signed and sealed by Tomas L. Shelmerdine, P.E.

  
07/09/2015


Carlos M. Utrera, P.E.


Product Control Examiner

NOA No. 15-0505.10


Expiration Date: October 4, 2017

Approval Date: July 16, 2015

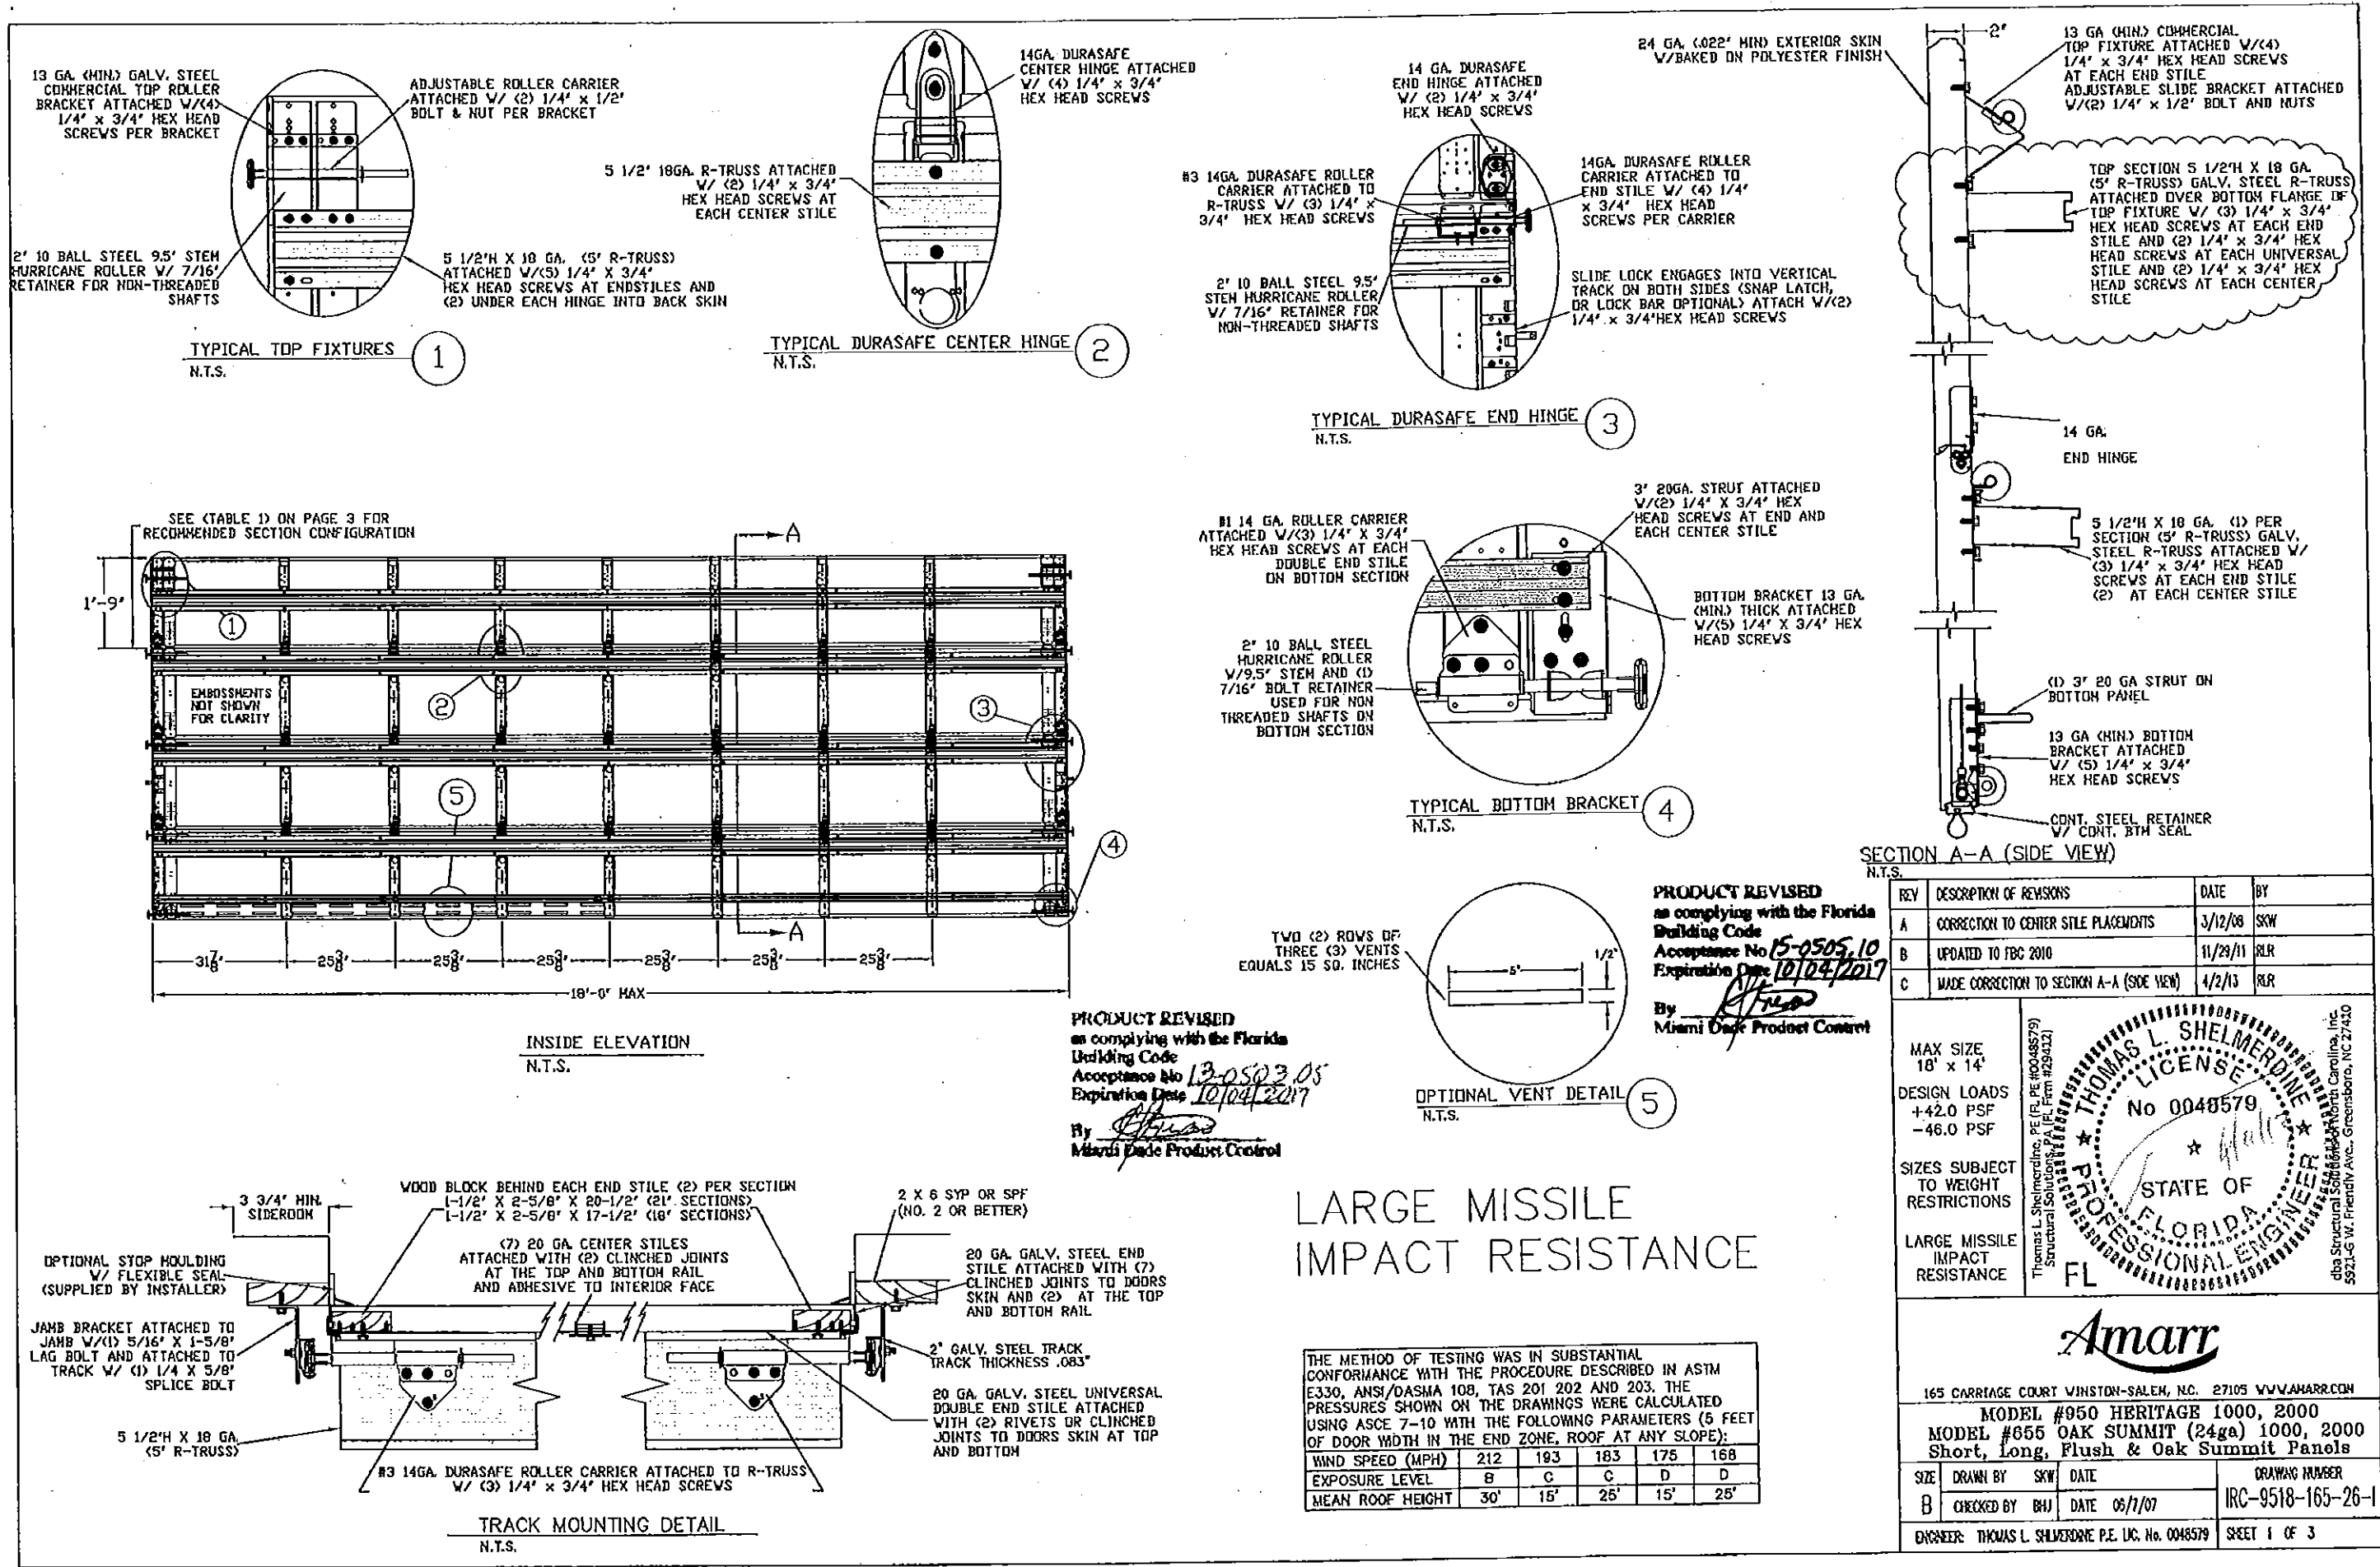

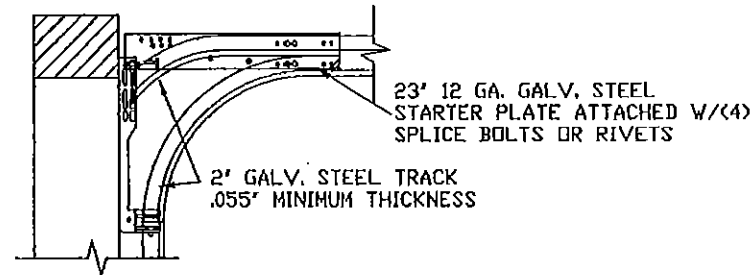


LOW HEADROOM TRACK OPTION  
N.T.S.

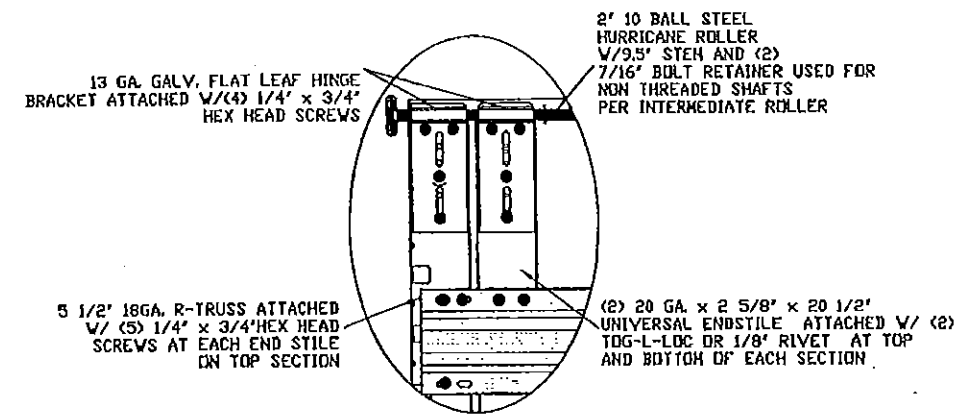

ALT. LOW HEADROOM TOP FIXTURE (1B)  
N.T.S.

13 GA. FLAG BRACKET ATTACHED TO WOOD JAMB W/ (3) 5/16 DIA. X 1-5/8' LAG BOLTS AND TO TRACK W/ (4) 1/4"-20 X 5/8' TRACK SPLICE BOLTS AND NUTS

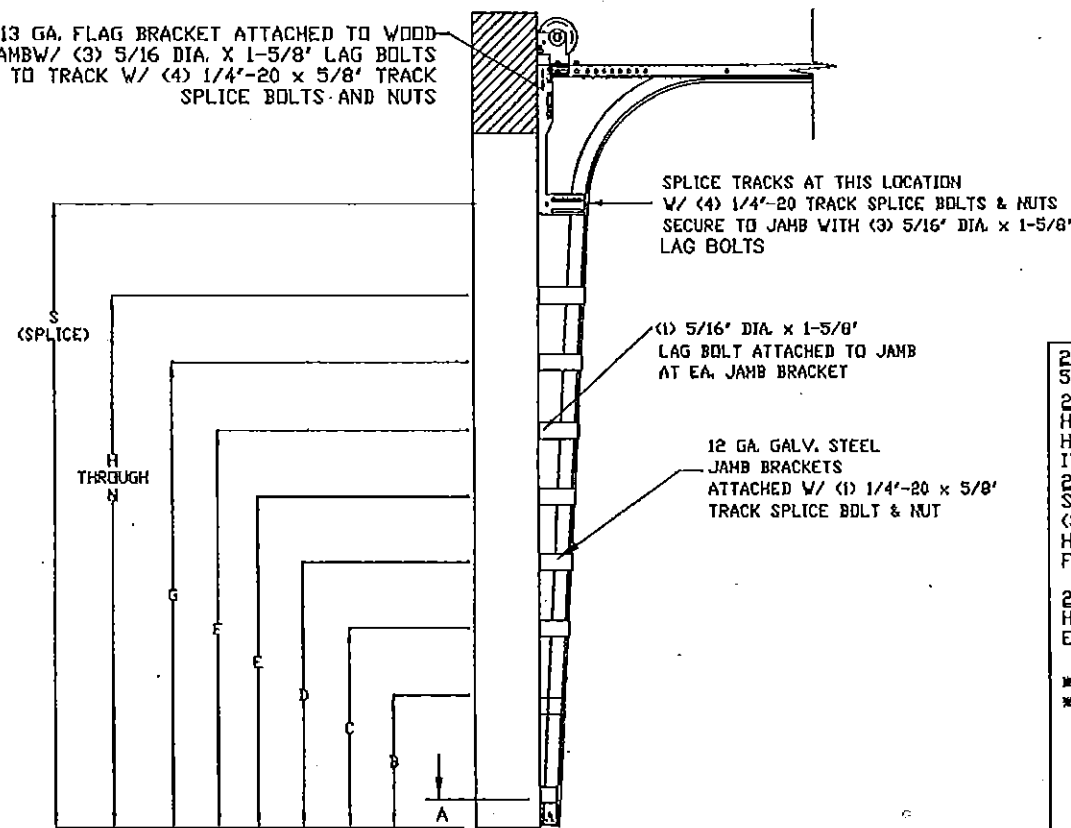

SEE (TABLE 2) FOR JAMB BRACKET SPACING

STANDARD TRACK CONFIGURATION FOR 6'6" UP TO 14' TALL DOORS  
N.T.S.

### WOOD JAMB ATTACHMENT TO STRUCTURE


**2 X 6 VERTICAL JAMB ATTACHMENT TO WOOD FRAME STRUCTURE**  
5/16" X 3' LAG SCREWS STARTING 6" FROM ENDS THEN 12" O.C. (1 1/2" EMBEDMENT)

**2 X 6 VERTICAL JAMB ATTACHMENT TO 2,000 PSI CONCRETE**  
HILTI KWIK BOLT 3/8" X 4' STARTING 6" FROM ENDS THEN 24" O.C. (2 1/2" EMBEDMENT)  
HILTI SLEEVE ANCHOR 3/8" X 2-3/4" STARTING 6" FROM ENDS THEN 10" O.C. (1 1/4" EMBEDMENT)  
ITW/RAMSET REDHEAD (TRU-BOLT) 3/8" X 4' STARTING 6" FROM ENDS THEN 22" O.C. (2 1/2" EMBEDMENT)

**2 X 6 VERTICAL JAMB ATTACHMENT TO HOLLOW C-90 BLOCK**  
SIMPSON 1/4" X 3' TITEN SCREWS STARTING 6" FROM ENDS, USE PAIRS OF FASTENERS (3" APART) AT 8" O.C. (1 1/2" EMBEDMENT)  
HILTI 1/4" X 2-3/4" KWIK-CON II+ SCREWS STARTING 6" FROM ENDS, USE PAIRS OF FASTENERS (3" APART) AT 8" O.C. (1 1/4" EMBEDMENT)

**2 X 6 VERTICAL JAMB ATTACHMENT TO GROUTED C-90 BLOCK (2000 PSI GROUT)**  
HILTI SLEEVE ANCHOR 3/8" X 2-3/4" STARTING 6" FROM ENDS THEN 12" O.C. (1 1/4" EMBEDMENT) (OR, USE FASTENERS FOR HOLLOW C-90 BLOCK)

\*LAGS AND BOLTS CAN BE COUNTERSUNK TO PROVIDE A FLUSH MOUNTING SURFACE.  
\*PREPARATION OF WOOD JAMBS BY OTHERS

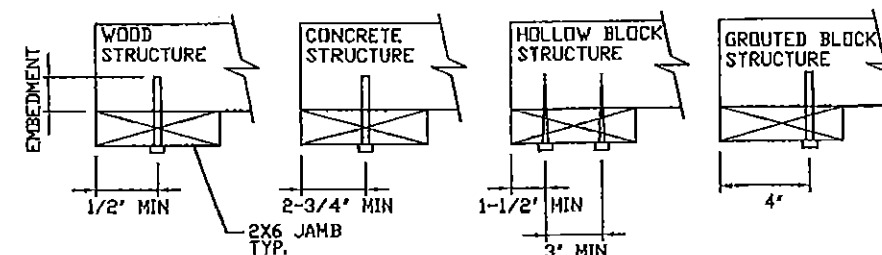

PRODUCT REVISED  
as complying with the Florida  
Building Code  
Acceptance No. 15-0505.10  
Expiration Date 10/04/2017  
By *[Signature]*  
Miami Trade Product Control

PRODUCT REVISED  
as complying with the Florida  
Building Code  
Acceptance No. 13-0503.05  
Expiration Date 10/04/2017  
By *[Signature]*  
Miami Trade Product Control

REV	DESCRIPTION OF REVISIONS	DATE	BY
A	CORRECTION TO CENTER STILE PLACEMENTS	3/12/08	SKW
B	UPDATED TO FBC 2010	11/29/11	RLR
C	MADE CORRECTION TO SECTION A-A (SIDE VIEW)	4/2/13	RLR

MAX SIZE  
18' x 14'

DESIGN LOADS  
+42.0 PSF  
-46.0 PSF

SIZES SUBJECT  
TO WEIGHT  
RESTRICTIONS

LARGE MISSILE  
IMPACT  
RESISTANCE

Thomas L. Shelmerdine, P.E. (FL PE #0048579)  
Structural Solutions, PA (FL FIRM #29412)


**THOMAS L. SHELMERDINE**  
LICENSE  
No 0048579  
STATE OF  
FLORIDA  
PROFESSIONAL ENGINEER  
FL

dba Structural Solutions, Inc. 5921 G.W. Friendly Ave., Greensboro, NC 27410

165 CARRIAGE COURT WINSTON-SALEM, NC. 27105 WWW.AMARR.COM

MODEL #950 HERITAGE 1000, 2000  
MODEL #855 OAK SUMMIT (24ga) 1000, 2000  
Short, Long, Flush & Oak Summit Panels

SIZE	DRAWN BY	SKW	DATE	DRAWING NUMBER
B	CHECKED BY	BNJ	DATE 06/11/07	IRC-9518-165-26-1
ENGINEER: THOMAS L. SHELMERDINE P.E. LIC. No. 0048579				SHEET 2 OF 3

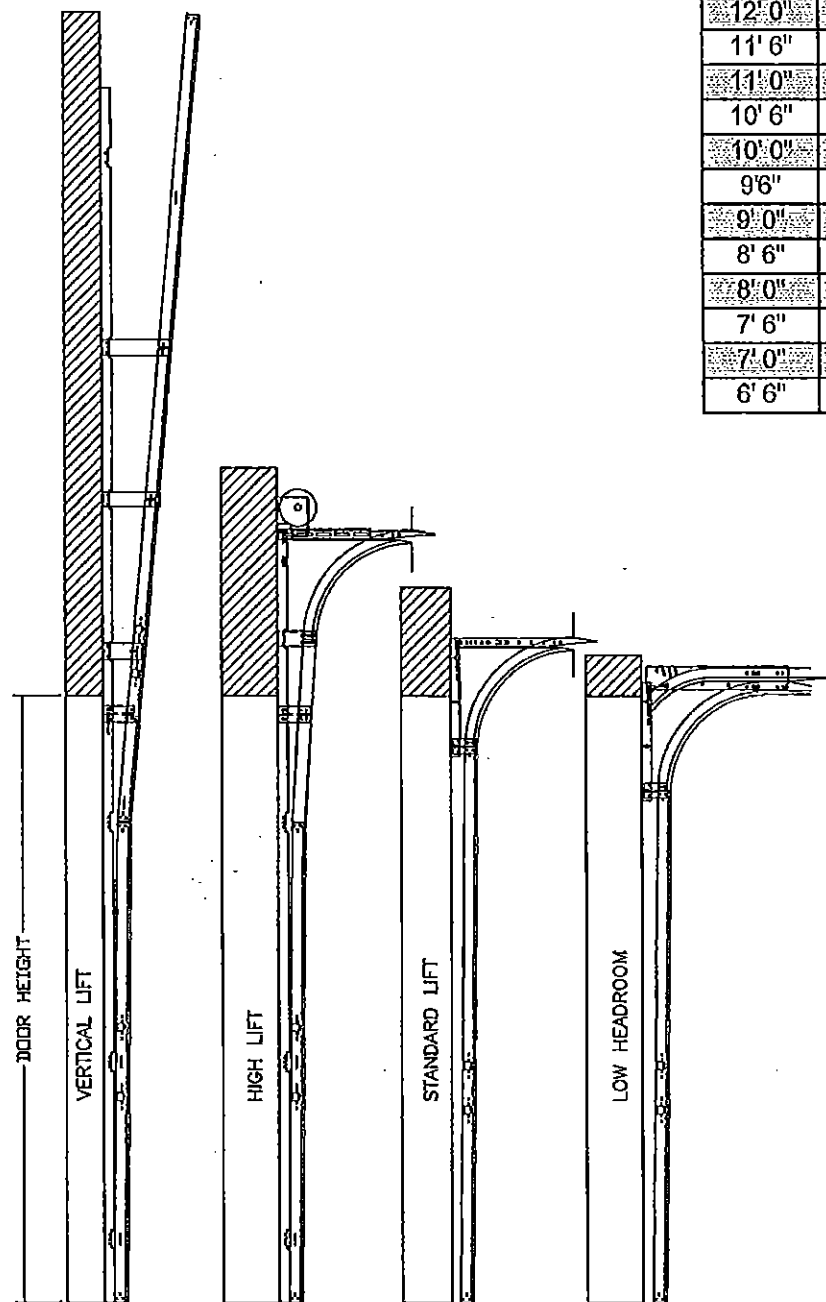

AVAILABLE TRACK CONFIGURATIONS  
N.T.S.


TABLE 1

DOOR HEIGHT	SECTION HEIGHTS							
	Btm	#2	#3	#4	#5	#6	#7	#8
14'0"	21"	21"	21"	21"	21"	21"	21"	21"
13'6"	21"	21"	21"	21"	21"	18"	18"	21"
13'0"	21"	21"	21"	18"	18"	18"	18"	21"
12'6"	21"	18"	18"	18"	18"	18"	18"	21"
12'0"	21"	21"	21"	21"	21"	18"	21"	
11'6"	21"	21"	21"	18"	18"	18"	21"	
11'0"	21"	18"	18"	18"	18"	18"	21"	
10'6"	21"	21"	21"	21"	21"	21"		
10'0"	21"	21"	21"	18"	18"	21"		
9'6"	21"	18"	18"	18"	18"	21"		
9'0"	18"	18"	18"	18"	18"	18"		
8'6"	21"	21"	21"	18"	21"			
8'0"	21"	18"	18"	18"	21"			
7'6"	18"	18"	18"	18"	18"			
7'0"	21"	21"	21"	21"				
6'6"	21"	18"	18"	21"				

TABLE 2

DOOR HEIGHT	TRACK ATTACHMENT															SPLICE
	A	B	C	D	E	F	G	H	I	J	K	L	M	N	S	
6'6"	3"	14"	27"	38"	46"	56"	64"									70"
7'	3"	14"	27"	38"	46"	56"	68"									76"
7'6"	3"	14"	27"	38"	46"	56"	68"	78"								82"
8'	3"	14"	27"	38"	46"	56"	68"	78"								88"
8'6"	3"	14"	27"	38"	46"	56"	68"	78"	88"							94"
9'	3"	14"	27"	38"	46"	56"	68"	78"	88"							100"
9'6"	3"	14"	27"	38"	46"	56"	68"	78"	88"	98"						106"
10'	3"	14"	27"	38"	46"	56"	68"	78"	88"	100"						112"
10'6"	3"	14"	27"	38"	46"	56"	68"	78"	88"	100"	110"					118"
11'	3"	14"	27"	38"	46"	56"	68"	78"	88"	100"	110"					124"
11'6"	3"	14"	27"	38"	46"	56"	68"	78"	88"	100"	110"	120"				130"
12'	3"	14"	27"	38"	46"	56"	68"	78"	88"	100"	110"	122"				136"
12'6"	3"	14"	27"	38"	46"	56"	68"	78"	88"	100"	109"	122"	132"			142"
13'	3"	14"	27"	38"	46"	56"	68"	78"	88"	100"	114"	122"	134"			148"
13'6"	3"	14"	27"	38"	46"	56"	68"	78"	88"	100"	109"	122"	134"	144"		154"
14'	3"	14"	27"	38"	46"	56"	68"	78"	88"	100"	114"	122"	134"	146"		160"

ALL TRACK ATTACHMENT SPACING +/-2" ALLOWED WITH SYP NO. 2 OR BETTER ONLY

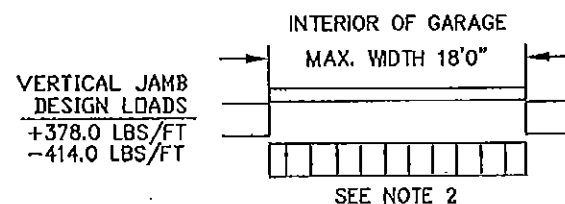

SPECIFICATIONS AND NOTES

1. ALL THE LOAD FROM THE DOOR IS TRANSFERRED TO THE VERTICAL TRACK, FROM THE TRACK THE LOAD IS TRANSFERRED TO THE VERTICAL JAMBS. THE HORIZONTAL JAMB OR HEADER RECEIVES NO PORTION OF THE LOAD TRANSFERRED FROM THE DOOR.
2. EACH VERTICAL JAMBS RECEIVES MAXIMUM DESIGN LOADS OF: +378.0 LBS/FT & -414.0 LBS/FT
3. DOOR AND HARDWARE WILL BE DESIGNED, MANUFACTURED AND INSTALLED WITH STANDARDS AS SET FORTH BY DASMA.
4. DOOR SECTIONS SHALL BE 24 GA. (.0216) MIN. EXTERIOR SKIN ROLLED FORMED, W/ BAKED ON POLYESTER FINISH
5. DOORS USE (1) 5.5" 18GA R-TRUSS PER SECTION AND (1) 3" 20GA STRUT ON THE BOTTOM SECTION.
6. REFER TO TABLE 1 FOR SECTION CONFIGURATION.
7. SUPPORTING STRUCTURAL ELEMENTS SHALL BE DESIGNED BY A REGISTERED PROFESSIONAL ENGINEER FOR WIND LOADS INDICATED ON THIS DRAWING IN ADDITION TO OTHER LOADINGS.
8. THIS APPROVAL REQUIRES THE MANUFACTURER TO DO TESTING OF ALL COILS USED TO FABRICATE DOOR PANELS UNDER THIS NOTICE OF ACCEPTANCE. A MINIMUM OF 2 SPECIMENS SHALL BE CUT FROM EACH COIL AND TENSILE TESTED ACCORDING TO ASTM E-8 BY A DADE COUNTY APPROVED LAB SELECTED AND PAID BY THE MANUFACTURER. EVERY 3 MONTHS, 4 TIMES A YEAR, THE MANUFACTURER SHALL MAIL TO THIS OFFICE: A COPY OF THE TEST REPORTS WITH CONFIRMATION THAT THE SPECIMENS WERE SELECTED FROM COILS AT THE MANUFACTURER PRODUCTION FACILITIES. AND A NOTARIZED STATEMENT FROM THE MANUFACTURER THAT ONLY COILS WITH YIELD STRENGTH OF 34,600 PSI OR MORE SHALL BE USED TO MAKE DOOR PANELS FOR DADE COUNTY UNDER THIS NOTICE OF ACCEPTANCE.

PRODUCT REVISED  
as complying with the Florida  
Building Code  
Acceptance No 13-0503.05  
Expiration Date 12/04/2017  
By [Signature]  
Miami Trade Product Control  
PRODUCT REVISED  
as complying with the Florida  
Building Code  
Acceptance No 15-0505.10  
Expiration Date 10/04/2017  
By [Signature]  
Miami Trade Product Control

REV	DESCRIPTION OF REVISIONS	DATE	BY
A	CORRECTION TO CENTER STILE PLACEMENTS	3/12/08	SKW
B	UPDATED TO FBC 2010	11/29/11	RLR
C	MADE CORRECTION TO SECTION A-A (SIDE VIEW)	4/2/13	RLR

MAX SIZE  
18' x 14'

DESIGN LOADS  
+42.0 PSF  
-46.0 PSF

SIZES SUBJECT  
TO WEIGHT  
RESTRICTIONS

LARGE MISSILE  
IMPACT  
RESISTANCE

Thomas L. Shelmerdine, P.E. (FL #0048579)  
Structural Engineering Firm #23412

Thomas L. Shelmerdine  
LICENSE  
No 0048579  
STATE OF  
FLORIDA  
PROFESSIONAL ENGINEER

dha Structural Solutions of North Carolina, Inc.  
5921-G W. Friendly Ave., Greensboro, NC 27410

Amarr

165 CARRIAGE COURT WINSTON-SALEM, NC. 27105 WWW.AMARR.COM

MODEL #960 HERITAGE 1000, 2000  
MODEL #665 OAK SUMMIT (24ga) 1000, 2000  
Short, Long, Flush & Oak Summit Panels

SIZE	DRAWN BY	SKW	DATE	DRAWING NUMBER
B	CHECKED BY	BHJ	DATE 06/1/07	IRC-9518-165-26-1

ENGINEER: THOMAS L. SHELMEERDINE P.E. LIC. No. 0048579 SHEET 3 OF 3